



Athletics Canada/Run Canada Measurement Certificate

Name of the course McDougall Road NE 300 m Cal. Course Distance 300 m
Location (city) Calgary (province) Alberta
Type of course: road race calibration ☒ track Configuration: Point to Point
Type of surface: paved ☒ dirt _____ gravel _____ grass _____ track _____
Elevation (meters above sea level) 1044 m
Straight line distance between start & finish 300 m Drop 0 m/km Separation 100 %
Measured by (name, address, phone & e-mail) Marcel LaMontagne 1827 Bay Shore Rd. SW,
Calgary, Alberta, T2V 3M2 403-874-1185
Contact (name, address & phone) _____
Measuring Methods: steel tape ☒ electronic distance meter
Number of measurements of entire course: two Date(s) when course measured: Nov. 15, 2008
Course paperwork submission date: Nov. 21, 2008
Replaces: _____ (if applicable) Certification code: _____


AB-2008-095-BDC

Be It Officially Noted That

Based on examination of data provided by the above named measurer, the course described above and in the map attached is hereby certified as reasonably accurate in measurement according to the standards adopted by the Road Running Technical Council. If *any* changes are made to the course, this certification becomes void, and the course must then be recertified.

Validation of Course — In the event a National Open Record is set on this course, or at the discretion of Athletics Canada/Run Canada, a validation remeasurement may be required to be performed by a qualified measurer. If such a remeasurement shows the course to be short, then all pending records will be rejected and the course certification will be cancelled.

AS NATIONALLY CERTIFIED BY:

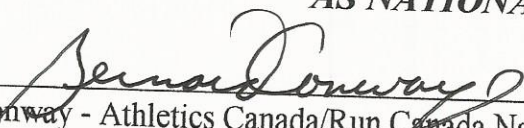
Bernard Conway - Athletics Canada/Run Canada National Certifier
- IAAF/AIMS Grade A Measurer
- USATF/RRTC Final Signatory

Date: Nov. 26, 2008

67 Southwood Crescent, London, Ontario, Canada, N6J 1S8
Phone: 519-641-6889 (H) Fax: 519-641-6889 E-mail: measurer@rogers.com

McDougall Rd NE 300m Calibration Course



Course measurer: Marcel LaMontagne 403.874.1185
 Course measured: November 1 5th, 2008

End points located with a pk nail & washer, painted, GPS referenced and measured to permanent objects.

Measured line is 2m500mm from curb line.


Reference Measurements
 (from west end point)
 manhole - 13m 380mm
 street light - 3m 900mm

51 03 03.2
 114 02 21.0
 1044m

Reference Measurements
 (from east end point)
 gutter - 7m 040mm
 street light - 3m 860mm

51 03 03.2
 114 02 05.8
 1044m
 Carewest
 George Boyack
 1070

McDougall Rd NE

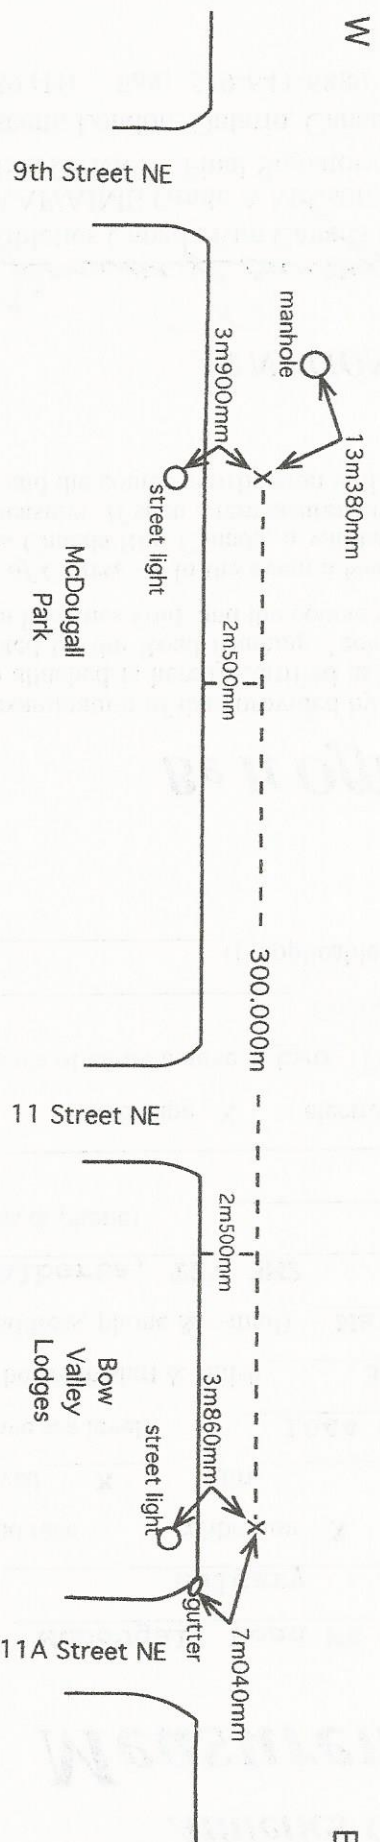

AB-2008-095-BDC

S